

STATE OF UTAH  
DEPARTMENT OF NATURAL RESOURCES  
DIVISION OF OIL, GAS AND MINING  
1594 West North Temple - Suite 1210  
Box 145801 Salt Lake City, Utah 84114-5801  
Telephone: (801) 538-5291  
Fax: (801) 359-3940

LARGE MINING OPERATIONS 2006 PROGRESS REPORT  
January 1, 2006 to December 31, 2006

The information required in this form are based on provisions of the Mined Land Reclamation Act, Title 40-8, and the rules as under the Utah Minerals Regulatory Program.

1. Mine Permit Number: **M470066**
2. Mine Name: **Diamond Mountain Resources Limestone Mine**
3. Name of Operator/Permittee: **Deseret Power / Diamond Mountain Resources**  
Note: If Operator's address, company representative or phone number have changed, please provide a replacement page to the Notice of Intention.
4. Mine Location:  
**UMC 363617 Diamond Mountain Resources # 9 SE ¼ Sec 16 T.1 South R.22 East**  
**UMC 363618 Diamond Mountain Resources # 10 SW ¼ Sec15 T.1 South R.22 East**  
**UMC 363624 Diamond Mountain Resources # 16 NE ¼ Sec21 T.1 South R.22 East**  
**UMC 363602 Diamond Mountain Resources # 17 NW ¼ Sec22 T.1 South R.22 East**
5. Report the gross amount of ore mined and waste moved, as well as the arrangement, positioning, or distribution of the material:  

Gross Ore Mined	<b>106,145</b>	Tons, or _____ yd <sup>3</sup>
Waste Material Moved	<b>30,000</b>	Tons, or _____ yd <sup>3</sup>
New Disturbance	<b>0</b>	Acres during 2006
Area Reclaimed	<b>2.7</b>	Acres during 2006
Total Disturbed Area	<b>17</b>	Acres*

Was the ore shipped off site? If not, where is the ore located? **58,047 tons shipped off site, the rest is stored on site.**

Where is the waste located? **Used on site to backfill pit area.**

\*Total life of mine disturbance to the end of 2006.
6. Briefly describe the reclamation work performed during the past year. A map showing reclaimed areas and dates is suggested. (Submit form MR-SITE for an application for full or partial bond/site release).  
**See map for reclaimed areas. The 2006 reclamation was as follows; the area around the generator sediment pond was reseeded to promote growth and hold the top soil, the East borrow ditch along the East pit access road was reseeded, two areas in quadrant G-5 and I-5 were also reseeded, and we seeded the topsoil pile. The topsoil pile is approximately three feet deep and 0.6 acres. We are not submitting form MR-SITE, as all seeded and reseeded areas are still considered new growth.**

Reviewed 2/16/09  
PMB

RECEIVED

JAN 30 2007

7. Include an updated map depicting surface disturbance and reclamation performed during the year, prepared in accordance with Rule R647-4-105.  
**Please see attached map.**

I hereby certify, under penalties of law, the information provided in this report is true and correct to the best of my knowledge and belief.


Name (Typed or Print): **Larry Jorgensen**

Title of Operator: **Operations Superintendent, Deseret Power**

Signature of Operator: *Larry Jorgensen*

Date: **Thursday, January 25, 2007**



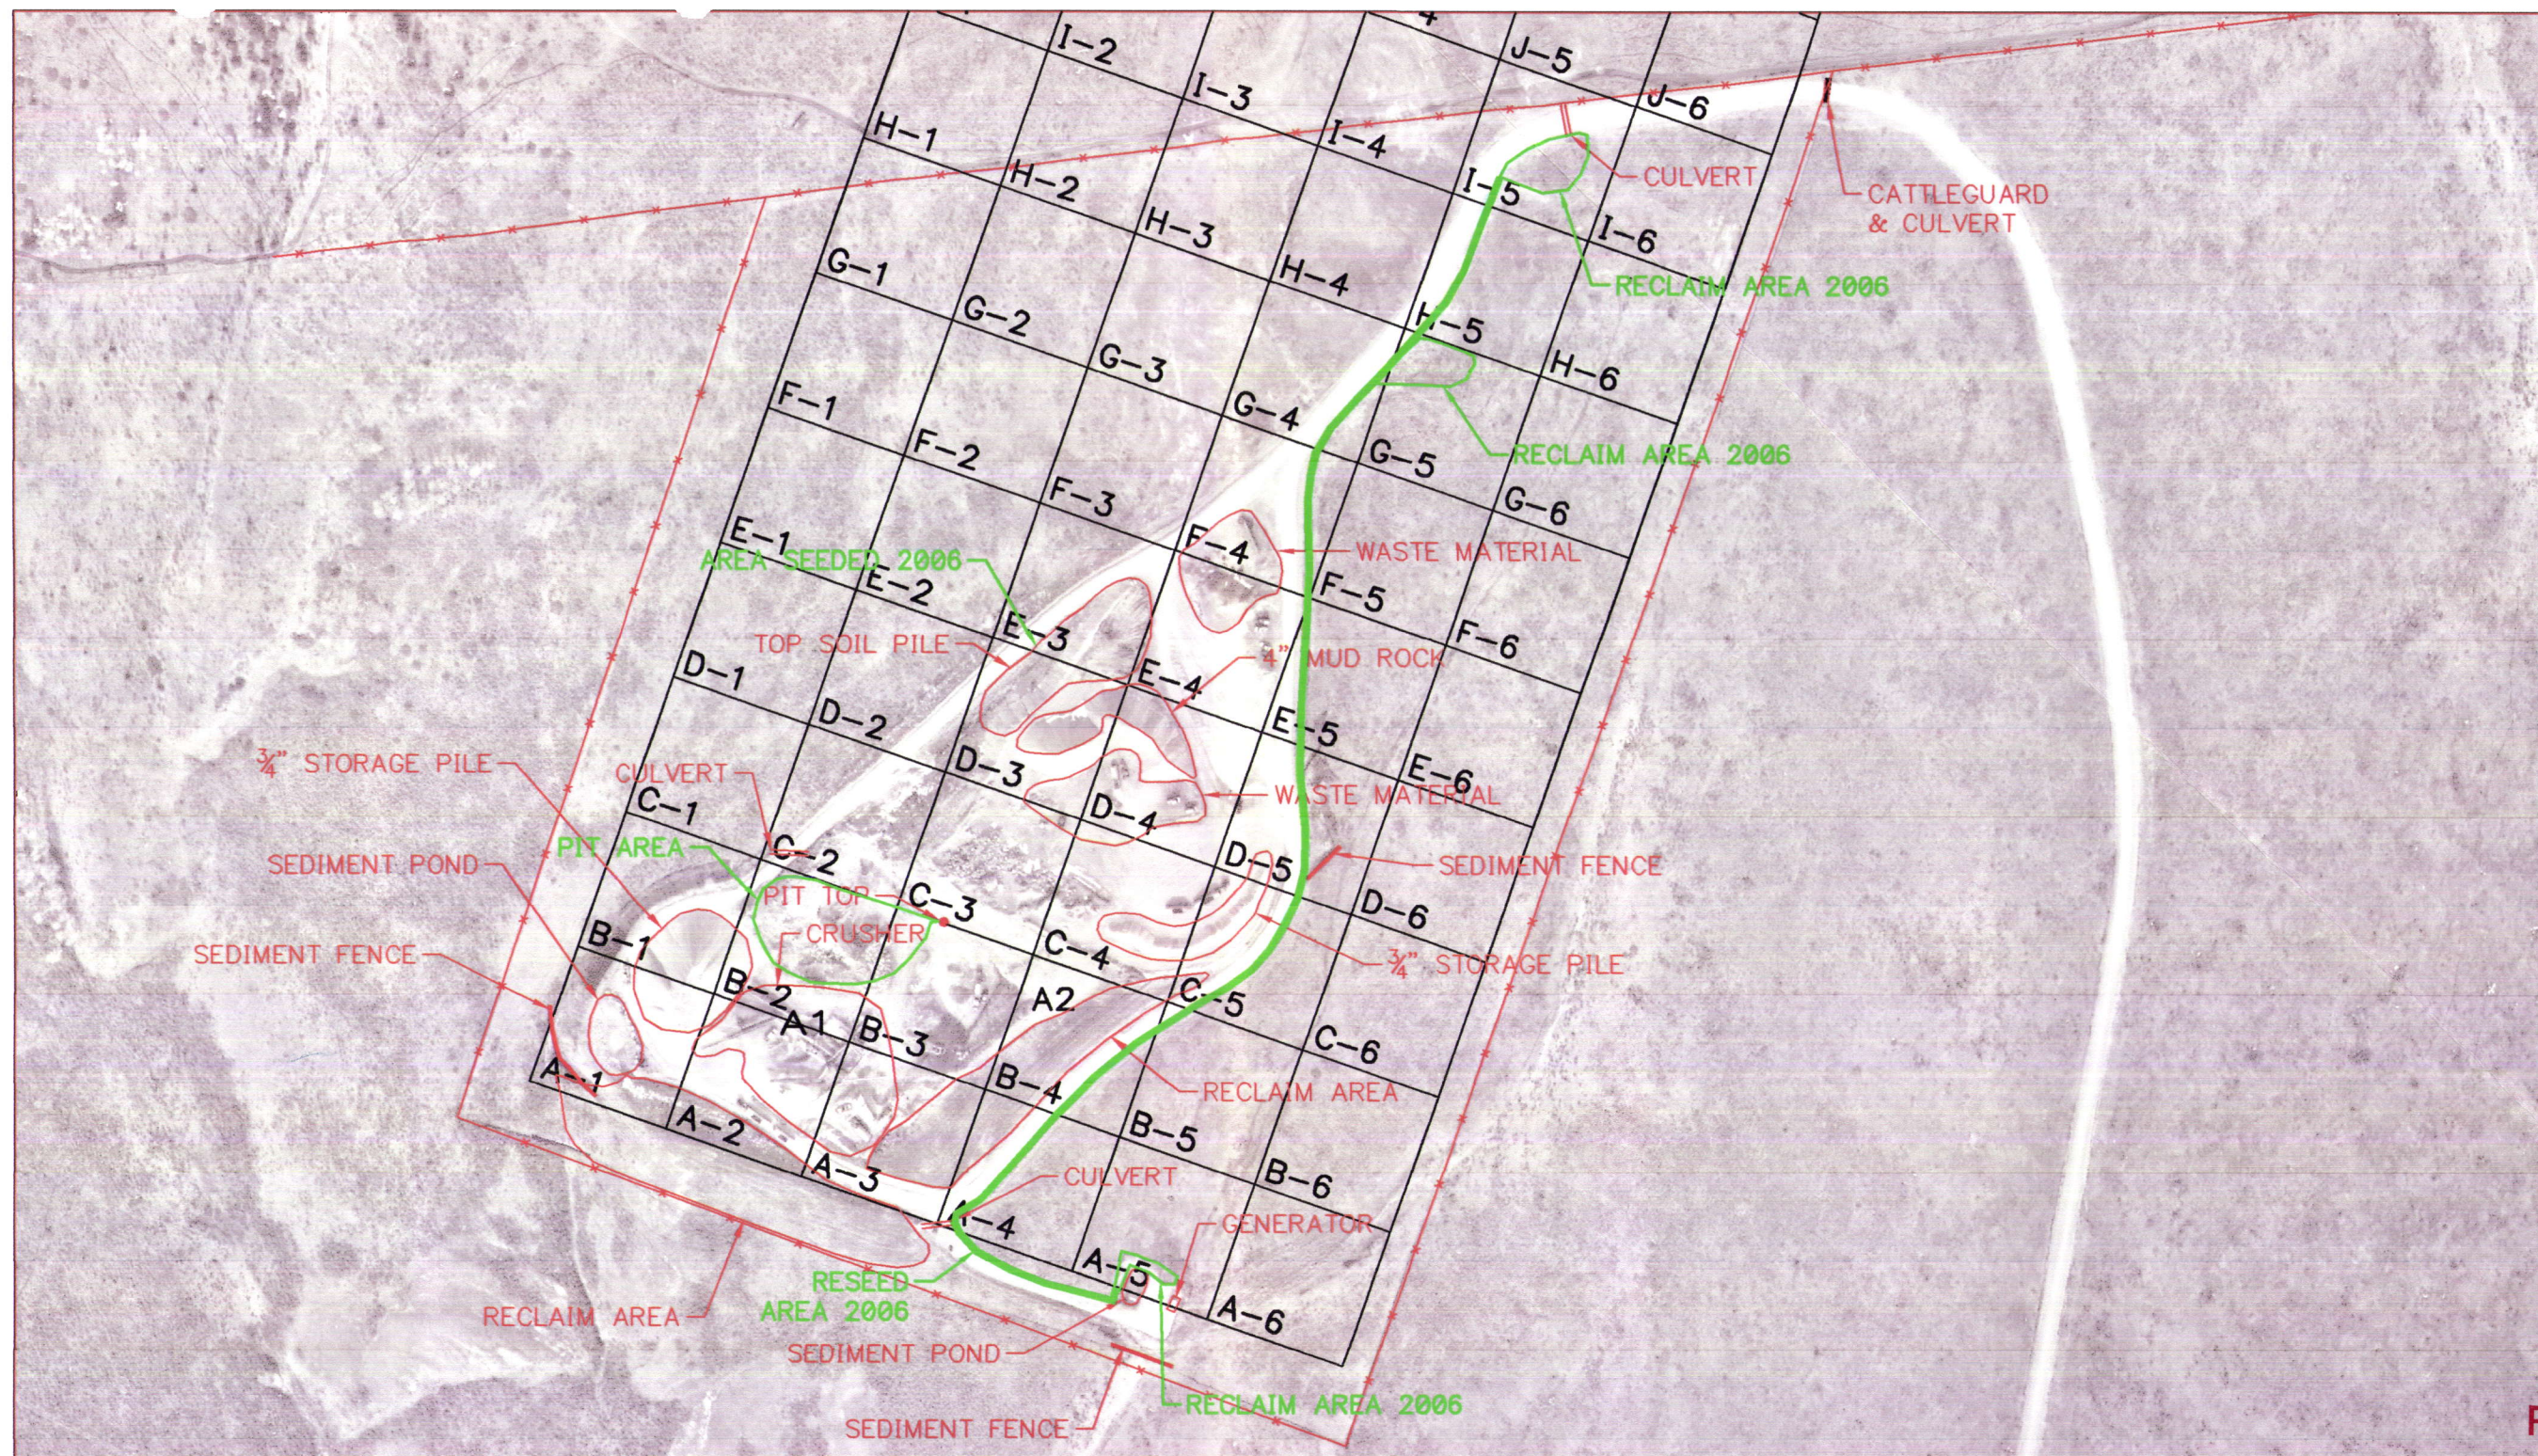

RECEIVED

JAN 30 2007

DIV. OF OIL, GAS & MIN.



TITLE: LIMESTONE MINE MAP  
2006 STATE REPORT

CAD FILE NAME: LIMESTONE20061114.DWG

					ENG			DRAFT			W.O. No.	
					ENG			DRAWN	KBS	1/07	DWG. No.	SHEET 1 OF 1
1	INITIAL RELEASE	1/07	BD	LJ	APVD			CHK	BD	1/07	061115-2	REV. 1
No.	REVISIONS	DATE	BY	APVD	PLOT SCALE: 1 = 1			APVD				